


完成図

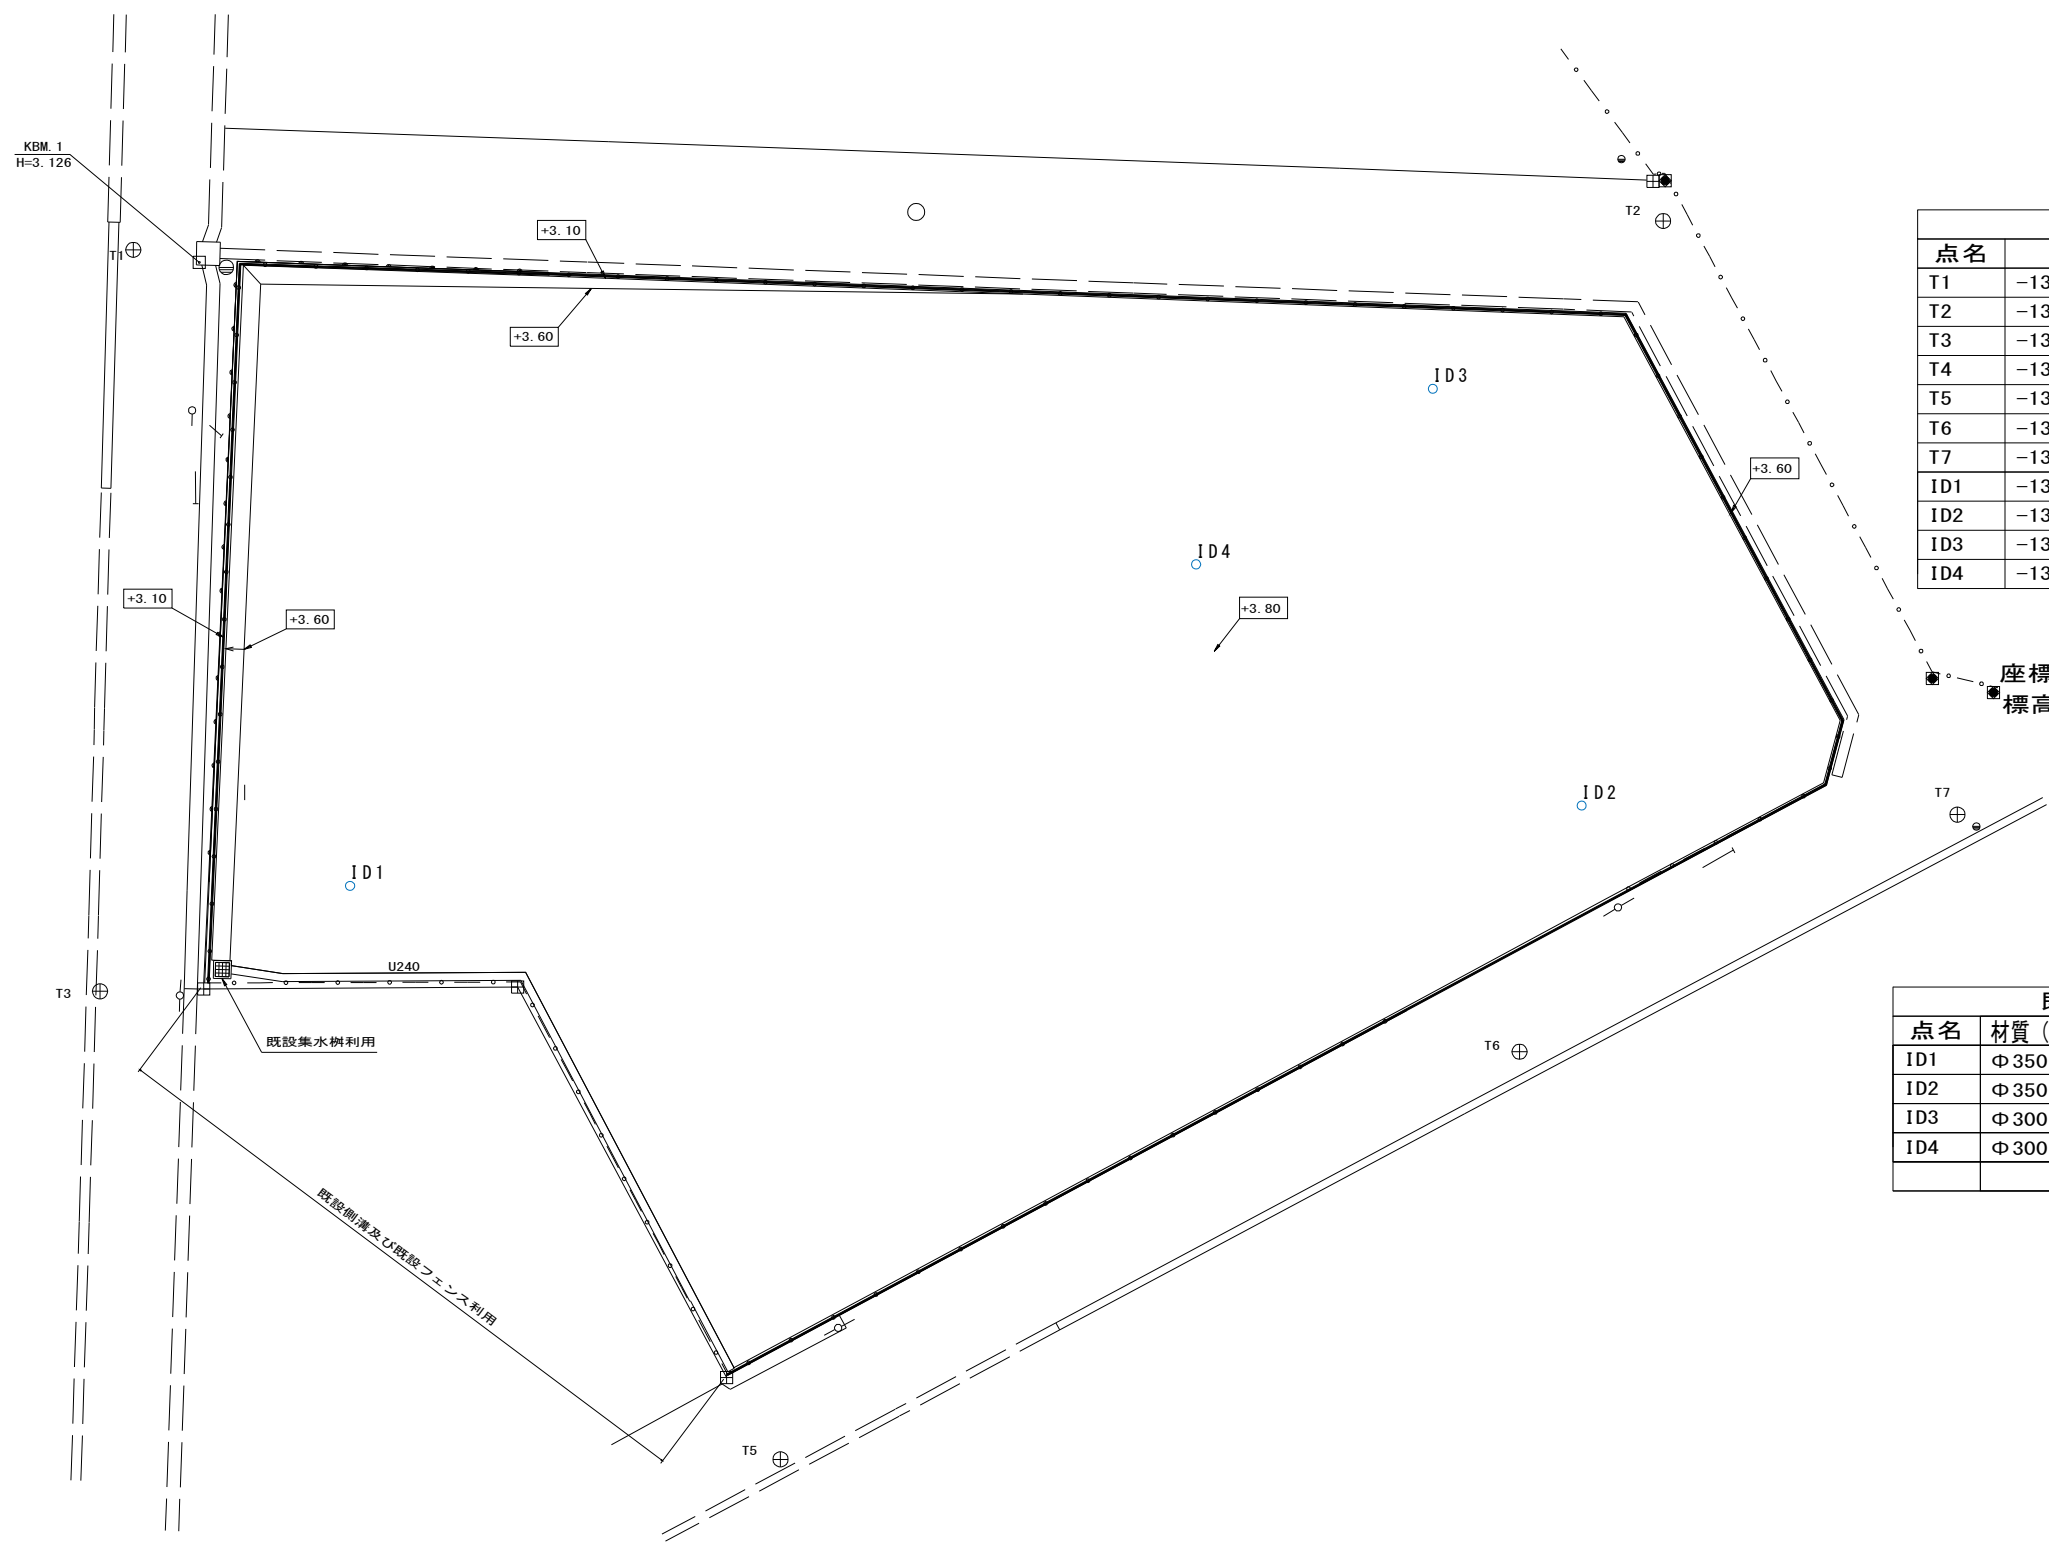

点名	X	Y	標高
T1	-138424.294	20133.895	3.127
T2	-138423.108	20196.908	3.686
T3	-138454.826	20132.521	3.080
T4	-138484.481	20133.806	3.169
T5	-138474.099	20160.550	3.491
T6	-138457.313	20190.993	3.759
T7	-138447.548	20209.029	3.777
ID1	-138450.482	20142.822	
ID2	-138447.180	20193.551	
ID3	-138430.015	20187.419	
ID4	-138437.245	20177.671	

座標は街区多角点使用世界測地系
標高は二等水準点第2929号使用

点名	材質 (鋼管)	GL	天端標高
ID1	Φ 350	-1070	2.51
ID2	Φ 350	-1000	2.70
ID3	Φ 300	-1200	2.40
ID4	Φ 300	-1800	1.98